


1200X450
S/S BENCH

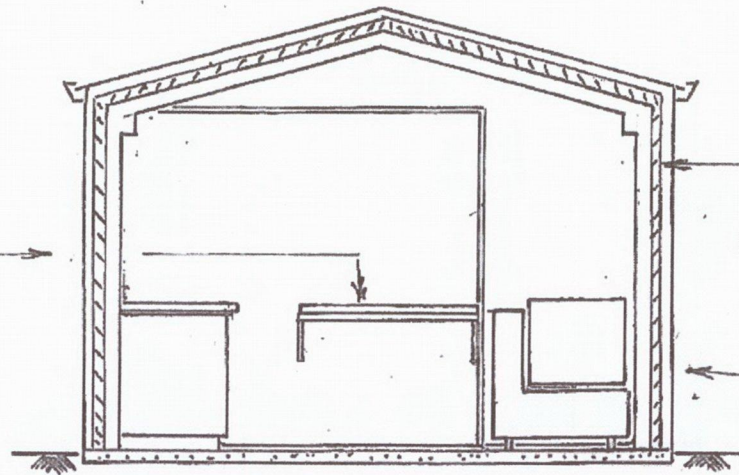


ELEVATION No 2

WALLS & CEILING
75mm METAL STUDWORK
12mm GYPROCK TO WALLS & CEILING
WITH FIBRE GLASS INSULATION

S/S MIXER
MACHINE

50mm PVC
COVING

SPINAWAY TURBO
VENTILATORS

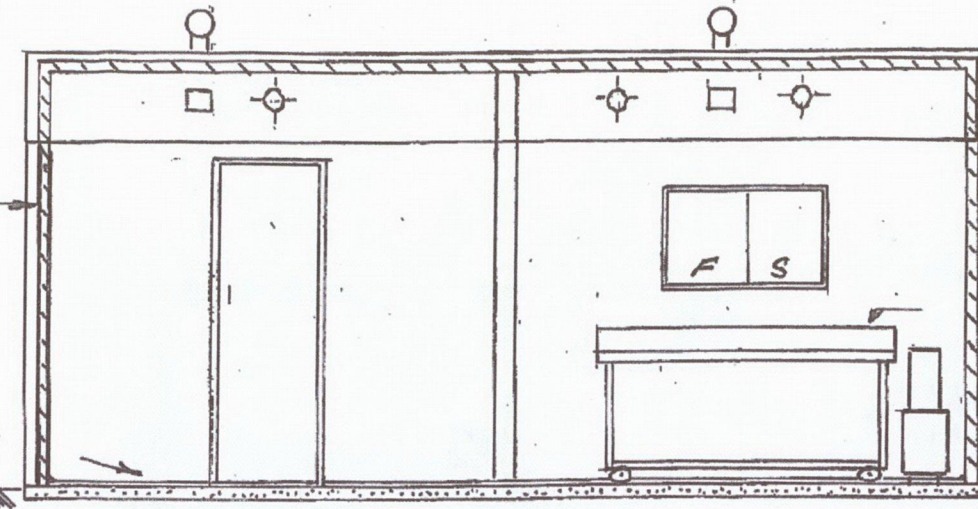


ELEVATION No 3

2.0X700
S/S BENCH


S/S FILTER
MACHINE

CUPBOARDS &
S/S TROUGH

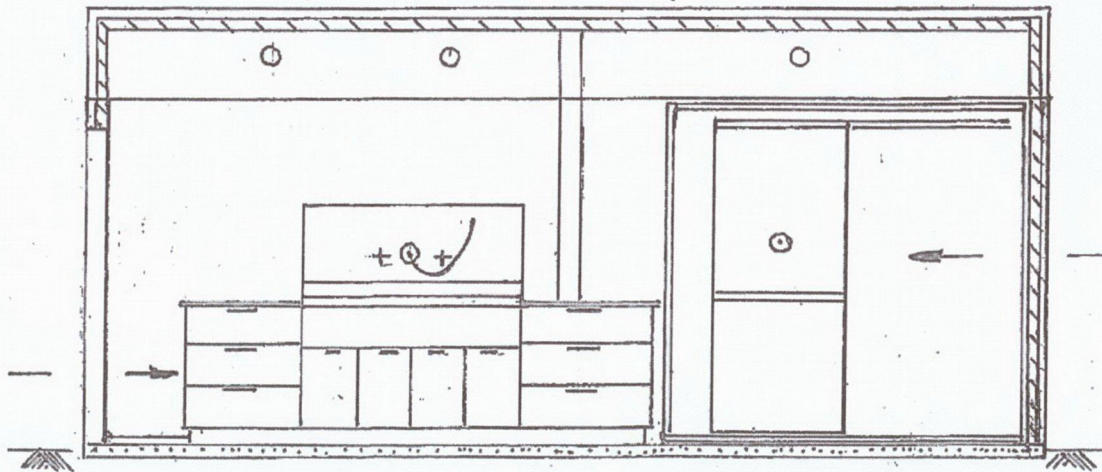

ELEVATION No 1

COOL ROOM
2.4X2.4X2.3

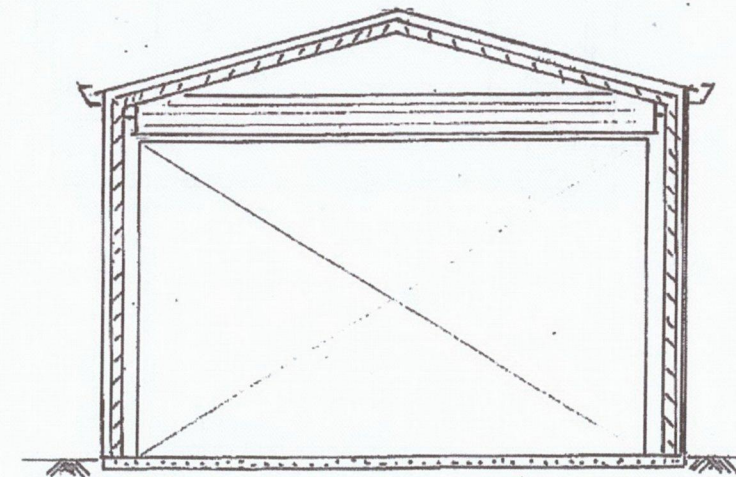


ELEVATION No 4

AS CONSTRUCTED FITOUT FOR SMALL GOOD PRODUCTION
WITHIN THE EXISTING APPROVD OUTBUILDING @
2 LIMTTA GROVE LANDSDALE

SCALE 1:50

EXISTING APPROVED
OUT BUILDING

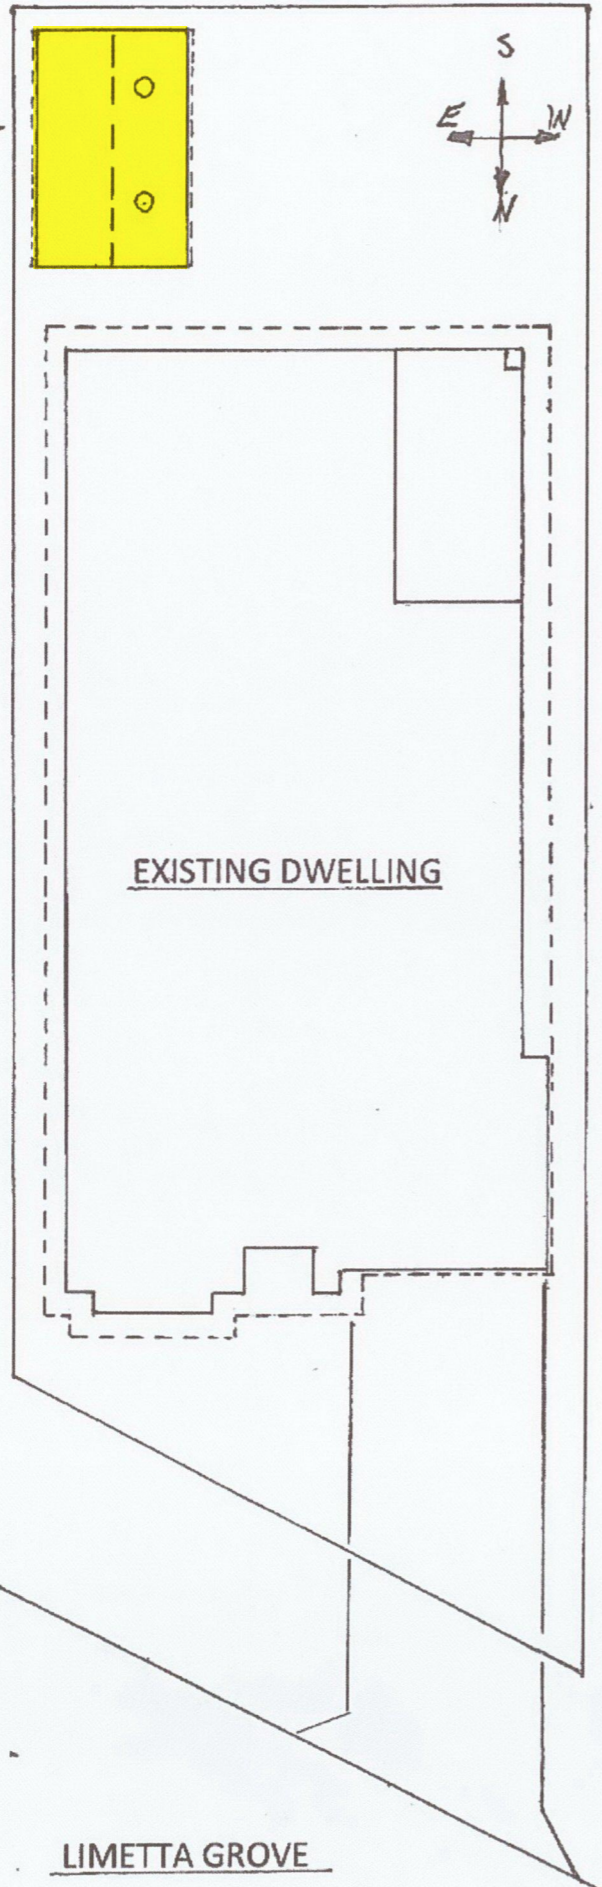


SITE PLAN

LIMETTA GROVE

SCALE 1:200 & 1:50

ROOF VENT

DOWN LIGHTS

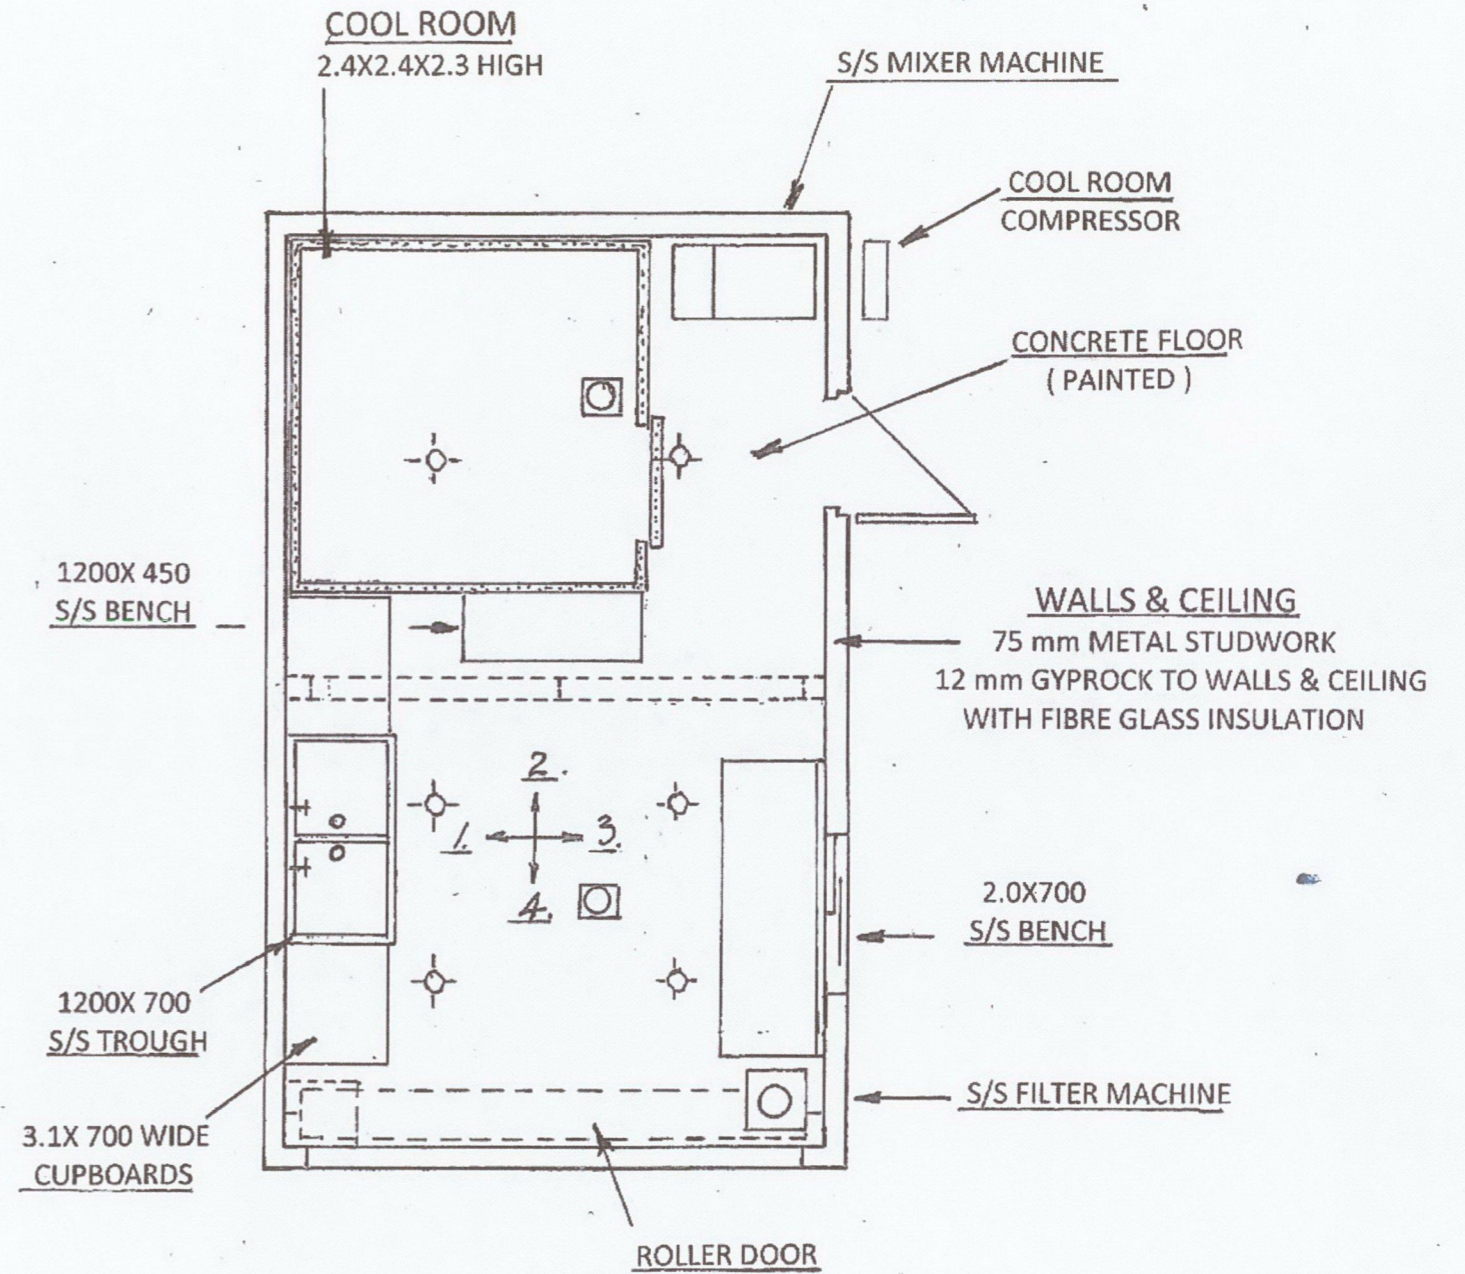

FITOUT PLAN

AS CONSTRUCTED FITOUT FOR SMALL GOODS PRODUCTION
WITHIN THE EXISTING APPROVED OUTBUILDING @
2 LIMETTA GROVE LANDSDALE